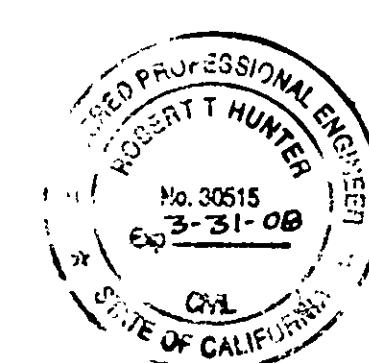
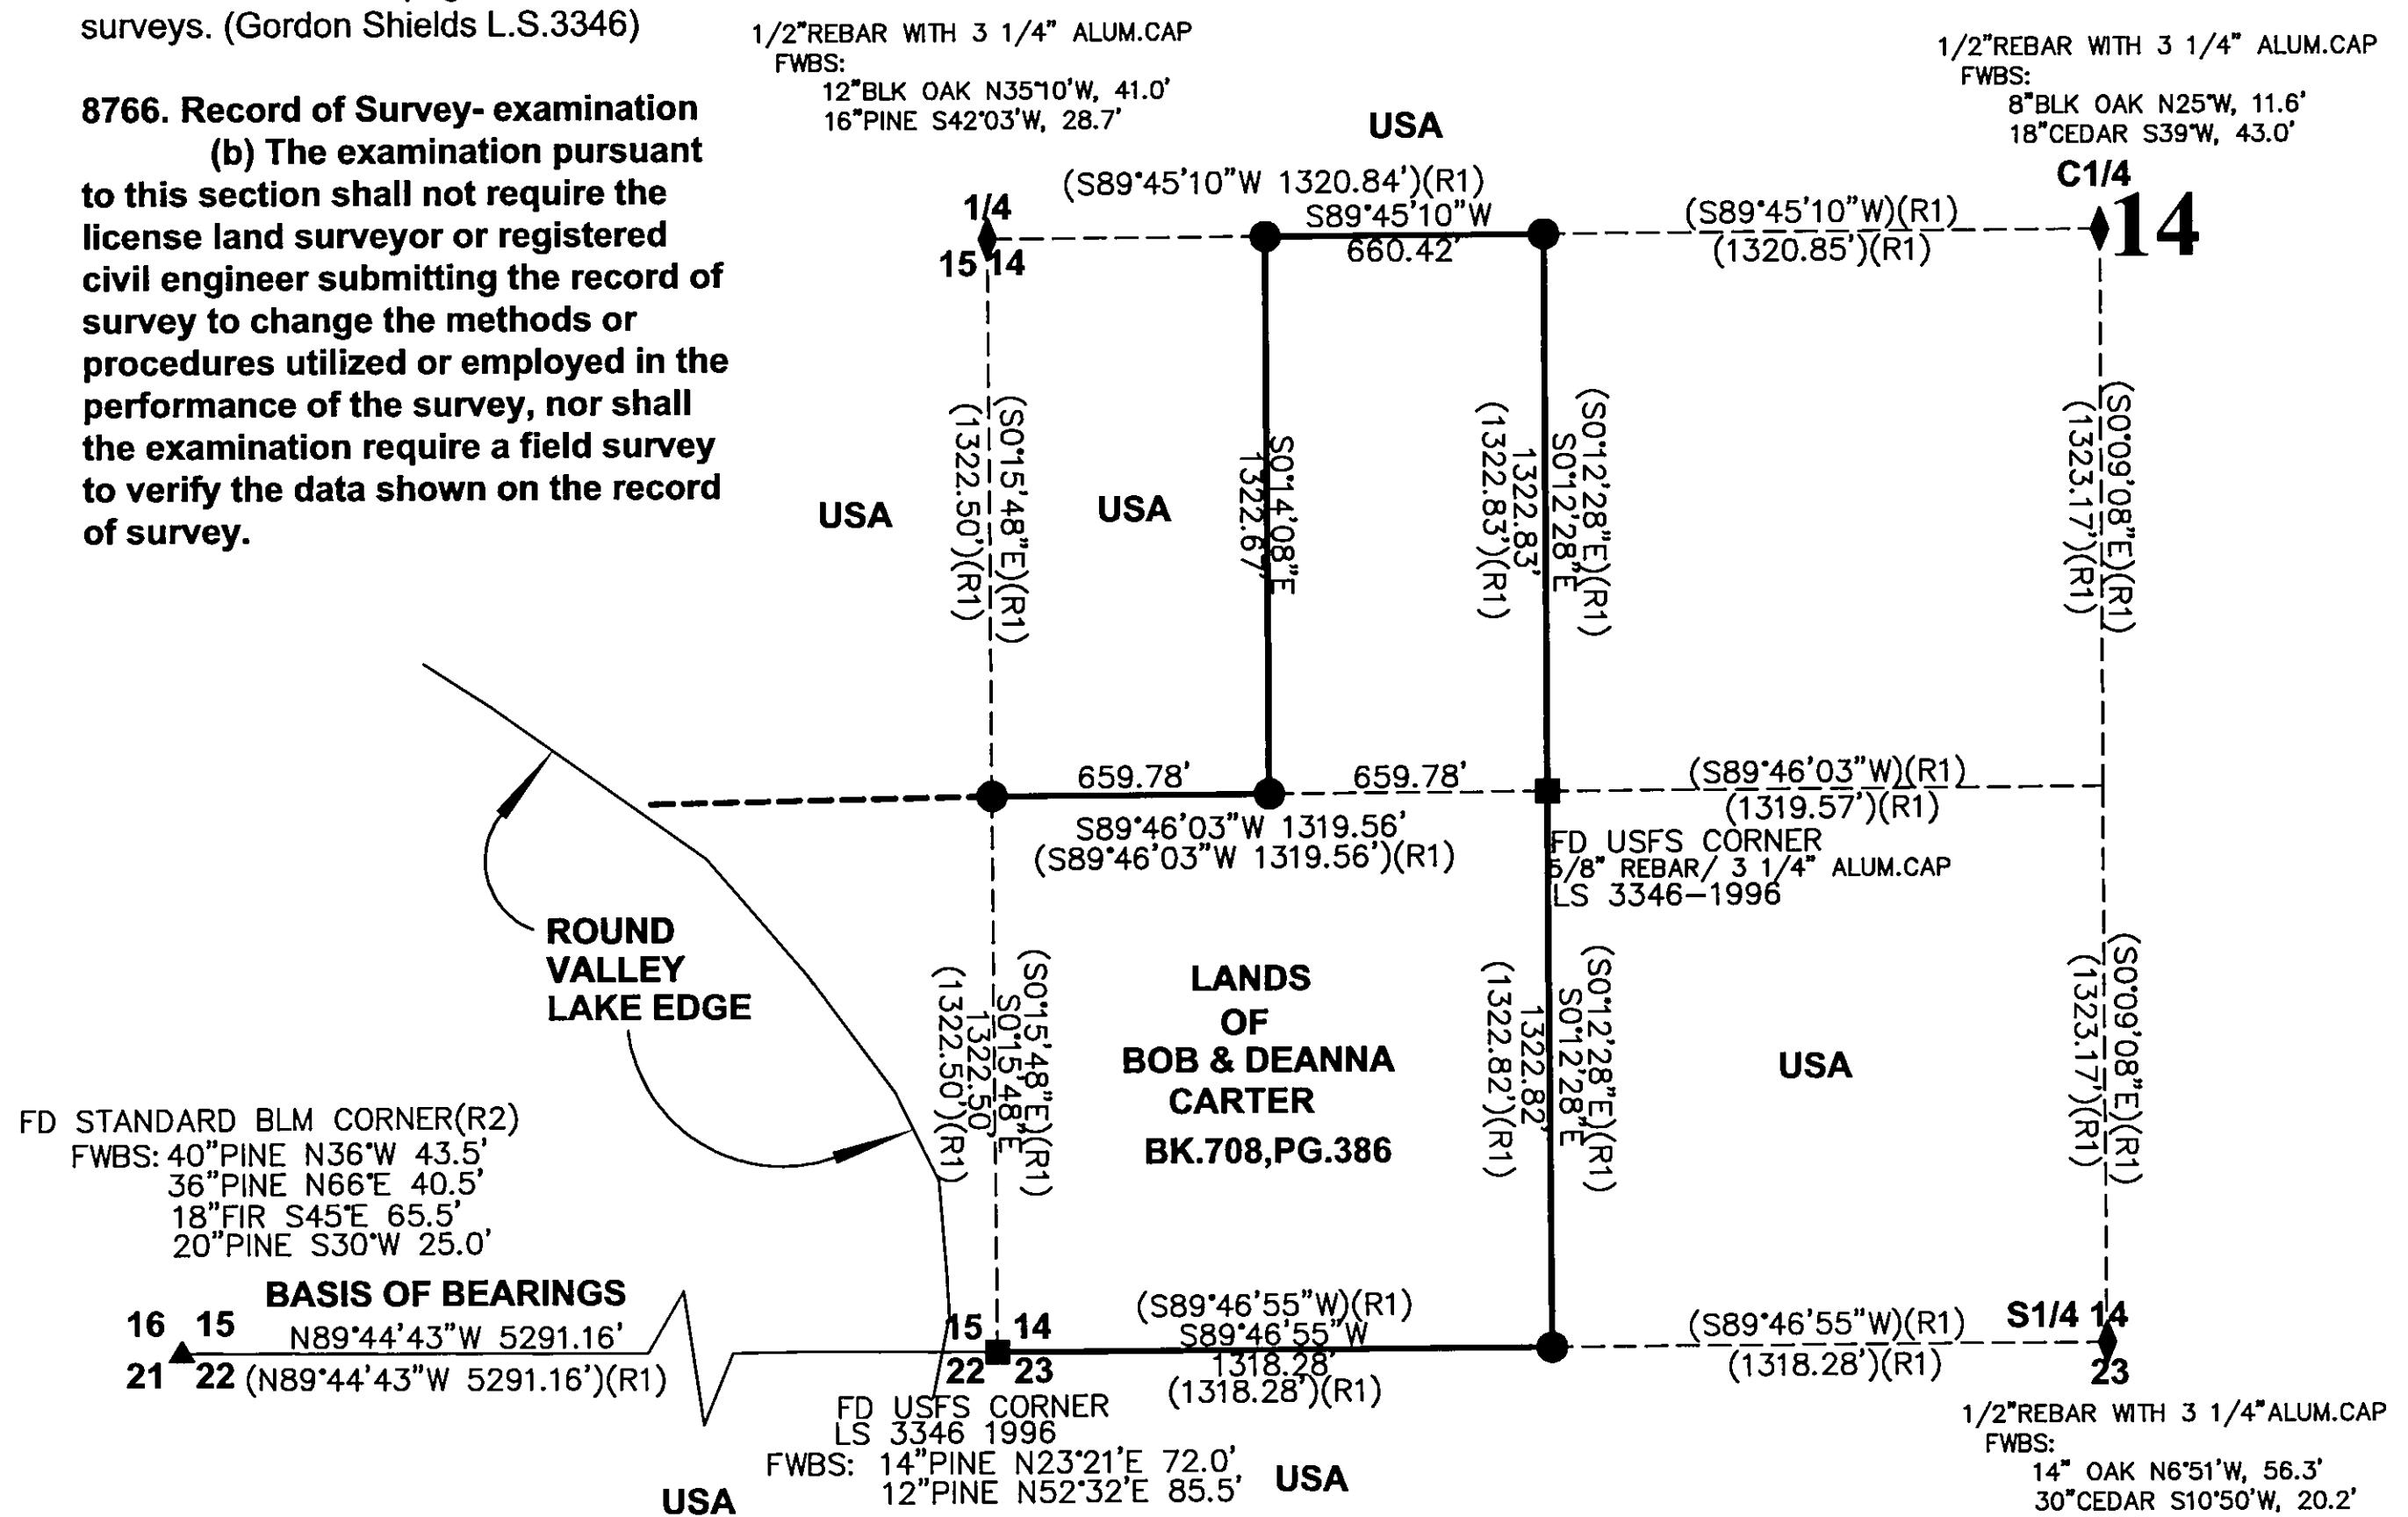


NOTE

This record of survey was constructed using field measurements to existing corners found as shown on this map and record data from a record of survey recorded in book 10 page 84 of record of surveys. (Gordon Shields L.S.3346)

8766. Record of Survey- examination

(b) The examination pursuant to this section shall not require the license land surveyor or registered civil engineer submitting the record of survey to change the methods or procedures utilized or employed in the performance of the survey, nor shall the examination require a field survey to verify the data shown on the record of survey.

**SURVEYOR'S STATEMENT**

This map correctly represents a survey made by me or under my direction in conformance with the requirements of the Professional Land Surveyors' Act at the request of Bob and Deanna Carter in January, 2006.

William Glenn Snow L.S. 5623
License Exp. Date 12/31/06

COUNTY SURVEYOR'S STATEMENT

This map has been examined in accordance with Section 8766 of the Professional Land Surveyors' Act this 12th Day of April 2006.

R. Tom Hunter R.C.E. 30515
Plumas County Surveyor
License Exp. Date 03/31/08

RECORDER'S STATEMENT

Filed this 24th day of April, 2006 at 1:04 p.m.
in Book 14 of Records of Surveys, at page 30
at the request of the County Surveyor.

Kathleen Williams, County Recorder

Fee: 8.00
Doc. No: 2006-0002983

By: R. Tom Hunter
Deputy

RECORD OF SURVEY

SECTION 14, T26N R09E MDM
PLUMAS COUNTY, CALIFORNIA

FOR
BOB & DEANNA CARTER
P.O.BOX 959, GREENVILLE, CA 95947


MAY 2004
CREW:
B.SNOW
T.MASHEK

DRAWN BY: B.SNOW

SHEET 1 OF 1

VINCIENCY MAP
NO SCALE

3	2	1	6
10	11	12	7
ROUND VALLEY RESERVOIR	14	13	18
22	23	24	19
	R09E	R10E	

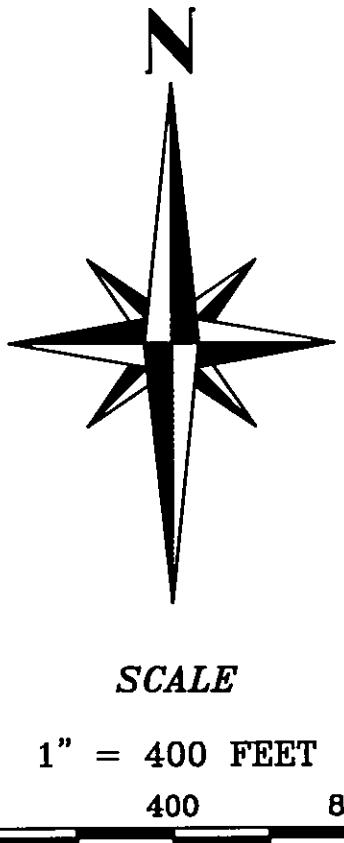**BASIS OF BEARING**

MEASURED BEARINGS ARE BASED ON THE MEASURED LINE BETWEEN THE SOUTHWEST CORNER OF SECTION 15 AND THE SOUTHWEST CORNER SECTION 14 AS PER RECORD OF SURVEY, RECORDED IN BK.10, PG.84 IN THE PLUMAS COUNTY RECORDS.

LEGEND

- ◆ RECORD CORNER SET AS PER 10RS84 MARKED LS3346 (GORDON SHIELDS)
- ▲ FD BLM CORNER AS PER 10RS84
- SET 5/8"REBAR W/PLASTIC CAP MARKED LS5623
- FD STANDARD U.S. FOREST SERVICE MONUMENT (AS PER 10RS84)
- CALC AS PER 10RS84
- PROPERTY BOUNDARY OF SURVEYED PARCEL

Snow Land Surveying Inc.

8736 DAMSELFY DR.
RENO, NV. 89523
(775) 787-8420

RECORD OF SURVEY

SECTION 14, T26N R09E MDM
PLUMAS COUNTY, CALIFORNIA

FOR
BOB & DEANNA CARTER
P.O.BOX 959, GREENVILLE, CA 95947

MAY 2004
CREW:
B.SNOW
T.MASHEK

DRAWN BY: B.SNOW

SHEET 1 OF 1